



HELLENIC GAS  
TRANSMISSION  
SYSTEM OPERATOR

357-359, MESSOGION AVE.,  
15231 ATHENS, GREECE  
Tel.: 210 6501258  
Fax : 210 6501551

TECHNICAL JOB  
SPECIFICATION

499/3

REVISION 0

DATE 05/04/2011

## HIGH PRESSURE (HP) TRANSMISSION SYSTEMS

### MEASURING-UP AND AS BUILT DOCUMENTATION

Job Spec. No 499/3  
 Revision 0  
 Date 05-04-2011  
 Page 2/89

**QUALITY ASSURANCE PAGE**
**CHANGES LOG**
**REVISIONS LOG**

0	05-04-2011	FIRST ISSUE	PQ DPT.	V.G.
Rev. No	Rev. Date	REASON FOR CHANGE	Made By	Approved By

Job Spec. No 499/3  
Revision 0  
Date 05-04-2011  
Page 3/89

CONTENTS

REFERENCE DOCUMENTS

- 1.0 SCOPE
- 2.0 EXTENT
- 3.0 MEASURING-UP
- 4.0 FORMAT OF DOCUMENTATION
- 5.0 PIPE-LOG
- 6.0 AS-BUILT DOCUMENTATION
- 7.0 APPENDIX A
- 8.0 APPENDIX B
- 9.0 APPENDIX C
- 10.0 APPENDIX D
- 11.0 APPENDIX E
- 12.0 APPENDIX F

Job Spec. No 499/3  
Revision 0  
Date 05-04-2011  
Page 4/89

**REFERENCE DOCUMENTS**

Job Spec. No. 180/1  
[Welding Inspection]

Job Spec. No. 181/2  
[Pressure Testing]

Job Spec. No. 199/4  
[Welding]

DIN 824  
[Technical drawings; Foldings to Filling Size]

**1.0 SCOPE**

This specification covers the requirements for the Measuring-up and As-built documentation for the installed Main Pipeline, the H.P. Branch Lines, as well the various types of the Gas Stations (Metering, Regulating, Compressor).

**2.0 EXTENT**

Contractor shall make all measurements and records that are necessary in order to comply with the requirements of the Contract.

After the successful execution of hydraulic test of a pipe section, the Contractor shall immediately deliver to Supervision, the required number of "red marked" copies which will consist the Final As-Built documents/drawings in order to be checked/commented and approved by the Supervision, and all the project information and data to be incorporated on the final documents.

After the approval of the Supervision the Contractor's "red marked" copies will be returned to Contractor in order to issue the final As-built document/drawings.

The pipe log shall be available to Supervision at any time as requested.

The Owner reserves the right to receive part of the As-built documentation prepared by Supervision or Surveyors.

In this case Owner will notify the Contractor in advance the above mentioned receipt and shall redefine the Contractor's scope of work.

The final documentation of the project is described on the attached list on APPENDIX A. The list also indicates the responsibility of Contractor, Supervision or the OWNER, to submit the parts of the documentation.

**3.0 MEASURING-UP**

For each welding (e.g. W42) shall be given the Km position, level (H), and coordinates X, Y. Coordinates X,Y and level (H) shall be given in each K point.

After backfilling top soil level should be checked as follows:

- a. Flat areas : Top soil level should be 0,30 m. more than the level shown on longitudinal sections IFC drawings (latest revision).
- b. Mountainous areas : Top soil level should be as the IFC level (latest revision).

Top soil level measurements shall be shown on the as-built longitudinal sections drawings.

The as-built survey shall be carried out using electronic survey equipment and data processing. The system used shall be in accordance with the Owner's requirements.

The survey data shall be handed over to the Supervision. Regarding longitudinal section, drawings shall be given in the form of CD ROMS. Contractor shall define: a. TEXT EDITOR, b. FILE FORMAT

Two lists of coordinates shall be prepared:

- a. 1st (based on the list of tangential intersection points as per basic engineering that will provided by the Owner) to include the intersections (K-points).

**Job Spec. No** 499/3  
**Revision** 0  
**Date** 05-04-2011  
**Page** 6/89

- b. 2nd to include the applied triangulation points, bench marks, repers during construction.

**4.0 FORMAT OF DOCUMENTATION**

The format of documentation shall be based on the sections of the pipeline as it is described on APPENDIX B.

All envelopes of the documentation shall be identified in accordance with the lists identification figures.

All documentation (pages and drawings) shall be perforated and inserted into binders of heavy duty quality, two (2) ring level mechanism with clear plastic pockets on both the front and the spine of the binder identification.

The standard width of the binder spine shall be 5 cm or 8 cm.

The binders shall be of such quality so that they can stand unsupported.

Drawings will be drawn to random length size for the convenience in binding. When larger drawings e.t.c. are included in the binder these shall be folded to fit into a plastic pocket page/or folded in accordance with **DIN 824** and fitted with wear resistance tabs to fit the binder.

A list of the titles for the as built documentation shall be provided on the front cover and the back one of the binder, giving project title, Owner logo, unit No. (see APPENDIX A, Fig. 1, 2 & 3).

All forms produced by the Contractor shall have on the top of the page the title of the subject and the following description (e.g.):

OWNER	HELLENIC GAS TRANSMISSION	
PROJECT	SYSTEM OPERATOR (DESFA S.A.)	SPREAD
CONTRACT NO	GREEK GAS PIPELINE	SECTION
SUPERVISION	xxxx/year	REF K. POINT
CONTRACTOR	xxxxxxxxxxxx	REF DWG's
	xxxxxxxxxxxxxxxxxxxx	DATE
		PAGE

**5.0 PIPE -LOG AND WELD LOG BOOK**

The CONTRACTOR shall maintain a complete, detailed and up-to-date record of all pipeline construction details in the form of a pipelog.

The pipe-log shall, as stated in the specification, comprise two sections.

The first section shall contain all details necessary for the pressure test of the pipeline section in subject. This shall be available at least 1 week prior to commencement of pressure testing.

The second section shall be a more detailed record of all construction details, including isometric sketches of all line installations, etc. (see APPENDIX D fig 1 & 2).

The Contractor shall submit be pipe log book prior to the submission of the red marked up drawings.

**6.0 AS-BUILT DOCUMENTATION**

The Contractor shall submit the documents splitted in sections according to the ones mentioned in basic engineering documents. Contractor shall get in contact with Supervision in order to finalise the sequence of the as-built documentation.

**Job Spec. No** 499/3  
**Revision** 0  
**Date** 05-04-2011  
**Page** 7/89

Contractor shall submit to Supervision the following As-Built documentation for checking/comments and/or approval:

**6.1 PIPE LOG AND WELD LOG BOOK**

As described in **para 5.0**.

**6.2 PRESSURE TEST DOCUMENTATION**

The pressure test documentation shall be in accordance with **Job Spec. No. 181/2** and shall contain test, test results, forms and graphs, e.t.c. The following reports are required which will be referred to the pipe section of pressure testing

PRESSURE TEST REPORT,	HYDROSTATIC TEST SUMMARY
	PERMIT FOR PIPELINE WATER FILLING AND HYDROTESTING
PRESSURE TEST REPORT,	DATA SHEET FOR PIPELINE SECTION TO BE FILLED WITH WATER (2 PAGES)
	WITH WATER (2 PAGES) CLEANING ACCEPTANCE CERTIFICATE PIGGING AND GAUGING PLATE LOG
PRESSURE TEST REPORT,	WATER FILLING RECORDS
PRESSURE TEST REPORT,	TEST REPORT, STABILIZATION EVALUATION OF TIGHTNESS TEST (4 PAGES)
PRESSURE TEST REPORT,	PRESSURE VS TEMP
PRESSURE TEST REPORT,	TIGHTNESS CALCULATION
PRESSURE TEST REPORT,	STRENGTH TEST
PRESSURE TEST REPORT,	HYDROSTATIC STRENGTH TEST
PRESSURE TEST REPORT,	TIGHTNESS TEST
PRESSURE TEST REPORT,	HYDROSTATIC TIGHTNESS TEST
	DIAGRAMS
PRESSURE TEST REPORT,	FAULT REPORT (2 PAGES)
PRESSURE TEST REPORT,	SUMMARY (3 PAGES)
PRESSURE TEST REPORT,	REPORT ON HYDROTESTING SECTION CROSSING, E.T.C.
PRESSURE TEST REPORT,	INSTRUMENT CALIBRATION REPORT
PRESSURE TEST REPORT,	PIPE LOG SUMMARY HYDROSTATIC TEST HISTORY DATA SHEET
	RECORDING MAP (SC. 1:50.000)
	LOCATION OF HYDROTESTING PIPELINE (SEE <b>APPENDIX C, FIG. 1 UP TO 29</b> ).

Contractor shall produce an index of all test sections.

**6.3 DRYING REPORT**

See **Appendix C, Fig. 30**.

**6.4 WELDING DOCUMENTATION**

The welding documentation shall consist of two sections. The first section include the welding documents and the second one the NDE documentation as per **Job Spec. No. 180/1** and **Job Spec. No. 199/4** and the approved Contractor's welding procedures.

**Job Spec. No** 499/3  
**Revision** 0  
**Date** 05-04-2011  
**Page** 8/89

#### 6.4.1 WELDING DOCUMENTS

- WELDING LOG.
- WELDING LOG BOOK.
- TIE-IN's REPORTS.
- WELDING PROCEDURES.
- WELDING PROCEDURE SPECIFICATIONS (WPS).
- PROCEDURE QUALIFICATION RECORDS (PQR)

#### 6.4.2 AUTHORIZED NDT DOCUMENTATION

- RADIOGRAPHS
  - RADIOGRAPHIC INSPECTION REPORTS
  - ULTRASONIC EXAMINATION REPORTS.
  - MAGNETIC PARTICLE EXAMINATION REPORTS.
  - LIQUID PENETRANT EXAMINATION REPORTS.
- (See APPENDIX D, Fig. 1 up to 9).
- NON CONFORMANCE REPORTS.

#### 6.4.3 CERTIFICATES FOR CONSUMABLES

#### 6.5 **CATHODIC PROTECTION**

The cathodic protection documentation shall consist of:

- PIN BRAZING AND CABLE CONNECTION FOR MEASURING POST REPORTS
- MEASURING POST INSTALLATION REPORTS
- INSTALLATION OF MEASURING POST AND CABLE CONNECTIONS RECORD SHEETS
- CHECK AND CALIBRATION OF POLARIZATION PROBES REPORT (POST TYPE K9).
- SOIL RESISTIVITY MEASUREMENTS.
- TEST REPORTS FOR RIVER CROSSING (TEMPORARY IMPRESSED CURRENT)
- TEST REPORTS FOR RIVER CROSSING.
- TEST REPORTS FOR ROAD/RAILWAY CROSSING WITH CASING.
- NATURAL POTENTIAL RECORD SHEETS (PRECOMMISSION WORKS ONLY).
- GROUND BED RECORD SHEETS.
- INSULATION JOINT TEST RESULTS.

(See **APPENDIX E, Fig. 1 up to 11**).

- 1:50.000 maps (key-plans) including all cathodic protection installed items (measuring posts, C.P. Station insulating couplings, e.t.c.).



**Job Spec. No** 499/3  
**Revision** 0  
**Date** 05-04-2011  
**Page** 9/89

- Test reports for grounding installation.
- Sketches for all electrical cables routing including the as built position of the measuring posts and splicing hits.
- Any other installed Cathodic Protection material such as bonding cables, e.t.c.

#### **6.6 COATING DOCUMENTATION**

The coating documentation shall consist of a summary of documents for coating of pipes, field joint, weld joints, valves and fittings as follows:

- PIPE COATING REPORTS (FIELD)
- VALVES AND FITTINGS COATING REPORTS

(See **APPENDIX F, Fig. 1 and 2**).

#### **6.7 HDPE PIPE (CONDUIT) DOCUMENTATION**

The HDPE pipe (conduit) documentation shall consist of a summary of documents from the installation and test reports as follows :

- INSTALLATION OF HOPE PIPE (CONDUIT) FOR FIBER OPTIC CABLE.
- HDPE PIPE TEST REPORTS. (See **APPENDIX F, Fig. 3 and 4**).

#### **6.8 MATERIAL CERTIFICATES AND VENDORS DRAWINGS**

For materials supplied by Owner, Contractor shall receive all the required documents from Owner in order to incorporate them in the final As-built documentation package. Contractor shall incorporate the above documents in a separate section of the as-built documentation package which should be indexed into types of material.

#### **6.9 PROTOCOLS AND OTHER DOCUMENTATION REQUIRED**

The documentation shall consist of a summary of documents as follows:

- MARKER POST INSTALLATION REPORTS
- PROTOCOLS FOR RIVER CROSSINGS
- PROTOCOLS FOR AUGER BORED CROSSINGS
- BORING REPORTS - SURVEY DATA
- HANDING OVER PROTOCOLS OF THE LAND AFTER THE REINSTATEMENT FROM THE CONTRACTOR

(See **APPENDIX F, Fig. 5 up to 9**).

#### **6.10 AS-BUILT DRAWING**

##### **6.10.1 GENERAL**

The as-built drawings shall be prepared by Contractor based on the I.F.C. Drawings on the latest revision and the Contractor's detailed field engineering drawings.

The as-built drawings shall contain all the as-built installations with information and details for the constructed Natural Gas Pipeline.

Before the issue of the as-built drawings the Contractor shall submit to Supervision for comments/approval two (2) copies of all the red marked as built documents/drawings referred to the pipeline section that have passed successfully all the tests. One copy of the above red marked as built drawings shall

**Job Spec. No** 499/3  
**Revision** 0  
**Date** 05-04-2011  
**Page** 10/89

be returned to Contractor with or without Supervision's comments in order to be included in the final as-built drawings.

Contractor shall include all Supervision's Comments in the final as-built drawings and shall issue to Supervision two (2) transparencies and six (6) copies of all final as-built drawings with transmittal form. (See **APPENDIX A, Fig. 3**).

Contractor shall also issue to Supervision all final as built drawings in digital form (CAD) in CD ROMS.

#### 6.10.2 DRAWINGS CLASSIFICATION

The Contractor shall submit to Supervision the following classification of drawings and lists.

<u>RECORDING MAPS</u>	Dwg Classification
- Recording Maps (1:50.000)	94
- Recording Maps (1:5.000)	93
- Recording Maps (1:1.000)	55
- Special Points, Recording Plans	58
- Geological Drawings	40
<u>LONGITUDINAL SECTIONS</u>	Dwg Classification
- Longitudinal Sections drawings (1:1.000)	55
- Special points, Long, section drawings	58
<u>ENGINEERING FLOW DIAGRAMS</u>	50
<u>PLANS FOR STATION AREA</u>	
- Plot Plan	41
- Foundation concrete structure (civil dwg)	43
- Piping Arrangement	51
- Isometrics	52
- Piping Layout	56
- Area classification drawings	
<u>CATHODIC PROTECTION SYSTEM</u>	
- Electrical Power	73
- Cathodic Protection Dwg	78
<u>SPECIAL CABLES INSTALLATION</u>	
- Instrument	65
<u>VARIOUS LIST</u>	
- List of tangential intersection points (k)	96
- List of class location classification	08
- List of hot and field bends	08

**Job Spec. No** 499/3  
**Revision** 0  
**Date** 05-04-2011  
**Page** 11/89

- List of crossings 58
- List of measuring posts 78
- List of saddles
- List of levels of the pipe and ground top between symbols of detailed dwg's (See **Appendix A, Fig. 6**)
- List of drawings
- List of documents

VENDORS' DRAWINGS (See Section 6.8)

6.10.3 OPERATING AND MAINTENANCE MANUALS FOR VENDOR EQUIPMENT

For equipment purchased by Owner he provide to Contractor a package of operating and maintenance manuals of the equipment, so that Contractor shall incorporate them in the as built documentation package.

6.10.4 LONGITUDINAL SECTIONS AND RECORDING PLAN

In the longitudinal sections and Recording Plan drawings shall be shown:

- The length of the pipeline.
- The starting and finishing pipeline kilometer Chainage shall be shown at the beginning and the end of each drawing.
- K-points, with all required data e.g. Grades / Degrees, kilometer chainage, kind of fittings, e.t.c.
- Match lines must be shown with dwg. nos., and kilometer chainage for the Special Points as Line Valve stations Scraper Stations, National Roads, New National Roads Railroads and River Crossings.
- The position (chainage) of main-valve shall be shown for all line valve station and scraper station.
- The Ownership and the detail description (material, dimensions, elevation, kilometer chainage, e.t.c.) of all existing underground installations (public or private) which are crossing the pipeline (e.g. water pipes, drainage pipes, fuel pipes, power cables, communication cables, e.t.c.).
- The as-built drawings shall have title blocks as shown on **APPENDIX A, Fig. 2**.

6.10.5 LONGITUDINAL SECTIONS

Regarding the longitudinal sections drawing (drawings class 55) it is up to the Contractor's judgment to decide for redrawing them if new elevations have been revealed after R.O.W. preparation, trenching and R.O.W. reinstatement activities.

If the Contractor decide to redraw the above mentioned drawings, then the redrawing shall be done with system compatible with the Owner's one.

In this case the contractor shall deliver also the drawings in the form of CD ROMS.

The following shall be shown on the drawings.

- The final ground levels after the reinstatement with chainage measured from the previous K-points.
- Top of pipe elevations with the chainage measured from the previous K-point.

**Job Spec. No** 499/3  
**Revision** 0  
**Date** 05-04-2011  
**Page** 12/89

- The pipeline shall be shown with double line without centerline. (see **APPENDIX A Fig.5**)
- The detail description and the exact location of each fitting (field bends, hot bends) at each K-point.
- The special protection shall be shown with abbreviations in the respective horizontal ROW due to the limited space
- The exact location and number (Quantity) for the installed saddles.
- The detail description dimensions, elevations of bottom of ditches and other dimensions for all crossings (e.g. roads, ravines, irrigation channels, e.t.c.).
- The Cathodic Protection Measuring Post type and location (chainage).
- All new K-points shall be numbered by using the respective lower K-point No. plus the next English alphabet letter.

#### 6.10.6 RECORDING PLAN

The Contractor shall use the basic engineering Recording Plans (transparencies) for the preparation of the as-built drawings.

The recording plans shall contain all information which are described in **para 6.10.6** as well as the requirements mentioned here below:

- The pipeline shall be shown with one line only, (see **APPENDIX A Fig.7**)
- The R.O.W. limits shall be shown with dotted lines.  
All R.O.W. limit changes (e.g. from 16m/10m to 8m/4m or 6m/6m e.t.c.) shall be shown.
- The weld joint Nos and locations shall be shown every third weld (approximately every 25 m.) For Details see **APPENDIX A, Fig. 7.**
- Measuring post numbering and exact location (kilometer chainage) shall be shown.
- Marker post numbering and exact location (kilometer chainage) shall be shown.
- All information within a zone of 40m/40m from the pipeline centerline shall be shown.

HDPE pipe (conduit) overlapping shall be shown.

All manholes and handholes shall be shown with their special symbols.

#### 6.11 **PHOTO DOCUMENTATION**

The Contractor shall submit 2 (two) sets of photographs documentation, plus the negatives, of all the stations.

The photographs will be taken after the coating has been completed, but before backfilling.

The photographs of the stations shall be top view (i.e. layout) and detail (side view), photographs of all equipment, fittings, e.t.c.




## HELLENIC GAS TRANSMISSION SYSTEM OPERATOR

Job Spec. No 499/3  
Revision 0  
Date 05-04-2011  
Page 13/89

### APPENDIX A


Job Spec. No 499/3  
Revision 0  
Date 05-04-2011  
Page 14/89

APPENDIX A - Fig. 1 (example)

 <p><b>HELLENIC GAS TRANSMISSION SYSTEM OPERATOR S.A.</b> <b>NATURAL GAS PROJECT OF GREECE</b></p>		
W.B.S.	CONTRACT NO.	ELEMENT CODE
<b>CONTRACT TITLE</b>		
<p>OWNER : DESFA S.A</p> <p>PROJECT MANAGER :</p> <p>SUPERVISION COMPANY :</p> <p>CONTRACTOR :</p>		
<b>FINAL DOCUMENTATION PACKAGE</b>		
<b>PROJECT TITLE</b>		
<b>UNIT</b>		
<b>FDP NUMBER</b>		<b>FDP DESCRIPTION</b>
PACKAGE VOLUME No :		COPY No :

Job Spec. No 499/3  
Revision 0  
Date 05-04-2011  
Page 15/89

APPENDIX A - Fig. 2 (example)



HELLENIC GAS TRANSMISSION  
SYSTEM OPERATOR S.A.

**FINAL  
DOCUMENTATION  
PACKAGE**

**PROJECT UNIT**

Contr. No :  
W.B.S.

**FDP DESCRIPTION**

**ELEMENT CODE**

**FDP NUMBER**


VOLUME No :  
COPY No :






Job Spec. No 499/3  
Revision 0  
Date 05-04-2011  
Page 17/89

**APPENDIX A - Fig. 4 (example)**

REFERENCE DRAWINGS								
5112-340-00-55-07 sh 2 of 2	SECTION 3400 - RECORDING PLAN							
5112-190/340-4-96-01	LIST OF TANGENTIAL INTERSECTION POINTS (KI)							
5112-190/340-4-58-01/11	LIST OF CROSSINGS							
5291-STD-00-11-06	FIELD BENDS OF PIPELINES SECTIONS							
5291-STD-1-43-13	CONCRETE SADDLE FOR PIPELINES							
5291-STD-00-58-04	PIPELINE WITHOUT CASING CROSSING WITH FUTURE ROAD							
5291-STD-00-58-05	PIPELINE WITH STEEL CASING CROSSING WITH FUTURE ROAD							
5291-STD-00-58-06	PIPELINE WITHOUT CROSSING WITH RAILWAY							
NOTE: LOCATION OF ELECTRIC COUPLING K241A2 + 158.81 m. COORDINATES : E: 488428.321 : N: 4203258.213 : Z: 163.375								
2	01.09.97	AS BUILT						
1	05.08.97	ISSUE FOR CONSTRUCTION						
0	04.06.97	FIRST ISSUE						
REV.	DATE	DESCRIPTION			DRAWN	CHK'D	ENGR	DEPT. HEAD
OWNER :  HELLENIC GAS TRANSMISSION SYSTEM OPERATOR, (DESFA) S.A.				APPROVED FOR CONSTRUCTION: REV <u>  1  </u> DATE <u>05.08.97</u>				
SUPERVISION :				"AS BUILT" CONTRACTOR :				
CONTRACTOR :				SIGNATURE DATE _____				
PROJECT : NATURAL GAS PROJECT (NGTS) HIGH PRESSURE TRANSMISSION SYSTEM XXXXXX PIPELINE				CONTRACT : No. XXX/XX W.B.S. No.				
DRAWING TITLE : Section XXXX XXXXXX - YYYYYY LONGITUDINAL SECTION FROM KXXX + XXX.XXm TO KXXX + XXX.XXm								
SCALE : 1 : 100 1 : 1000	DWG No. XXXX-YYY-00-55-XX			2	1 OF 2			
ACAD CODE :	AS BUILT:			REVISION	SHEET			


Job Spec. No 499/3  
Revision 0  
Date 05-04-2011  
Page 18/89

**APPENDIX A - Fig. 5 (example)**

REFERENCE DRAWINGS								
5112-340-00-55-07 sh 1 of 2	SECTION 3400 - LONGITUDINAL SECTION							
5112-340-00-55-07 sh 2 of 2	SECTION 3400 - RECORDING PLAN							
5112-340-00-58-29 sh 1 of 2	SECTION 3400 - DETAIL LONGITUDINAL SECTION							
2	21.06.00	AS BUILT						
1	31.01.00	ISSUE FOR CONSTRUCTION						
0	23.12.99	FIRST ISSUE						
REV.	DATE	DESCRIPTION					DRAWN	CHK'D
OWNER :  HELLENIC GAS TRANSMISSION SYSTEM OPERATOR, (DESFA) S.A.						APPROVED FOR CONSTRUCTION: REV <u>1</u> DATE <u>31.01.00</u>		
SUPERVISION :						"AS BUILT" CONTRACTOR :  _____ SIGNATURE  DATE _____		
CONTRACTOR :								
PROJECT : NATURAL GAS PROJECT (NGTS) HIGH PRESSURE TRANSMISSION SYSTEM XXXXXX PIPELINE						CONTRACT : No. XXX/XX W.B.S. No.		
DRAWING TITLE : Section XXXX XXXXXX - YYYYYY RECORDING PLAN FROM KXXX + XXX.XXm TO KXXX + XXX.XXm								
SCALE : 1 : 100 1 : 200		DWG No. XXXX-YYY-00-58-XX				2		2 OF 2
ACAD CODE : ..		AS BUILT:				REVISION		SHEET




**APPENDIX A - Fig. 7 (example)**

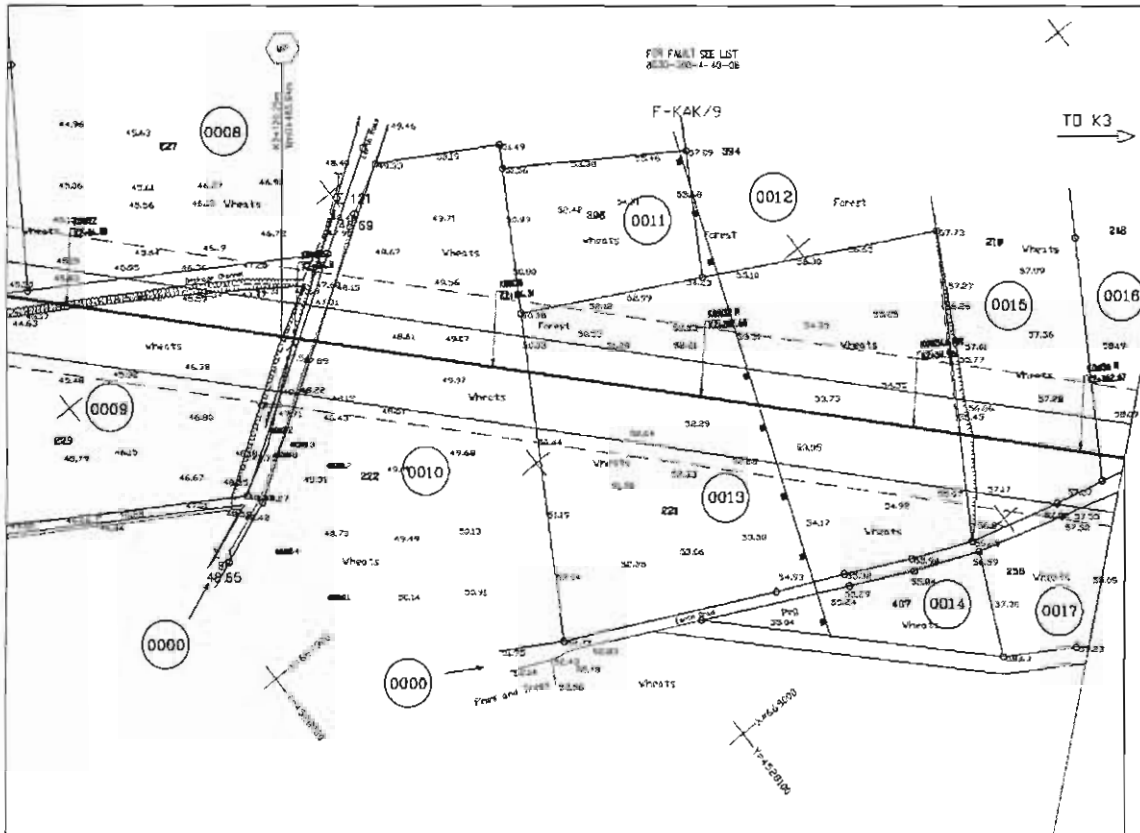

Job Spec. No 499/3  
Revision 0  
Date 05-04-2011  
Page 21/89

**APPENDIX A - Fig. 8 (example)**

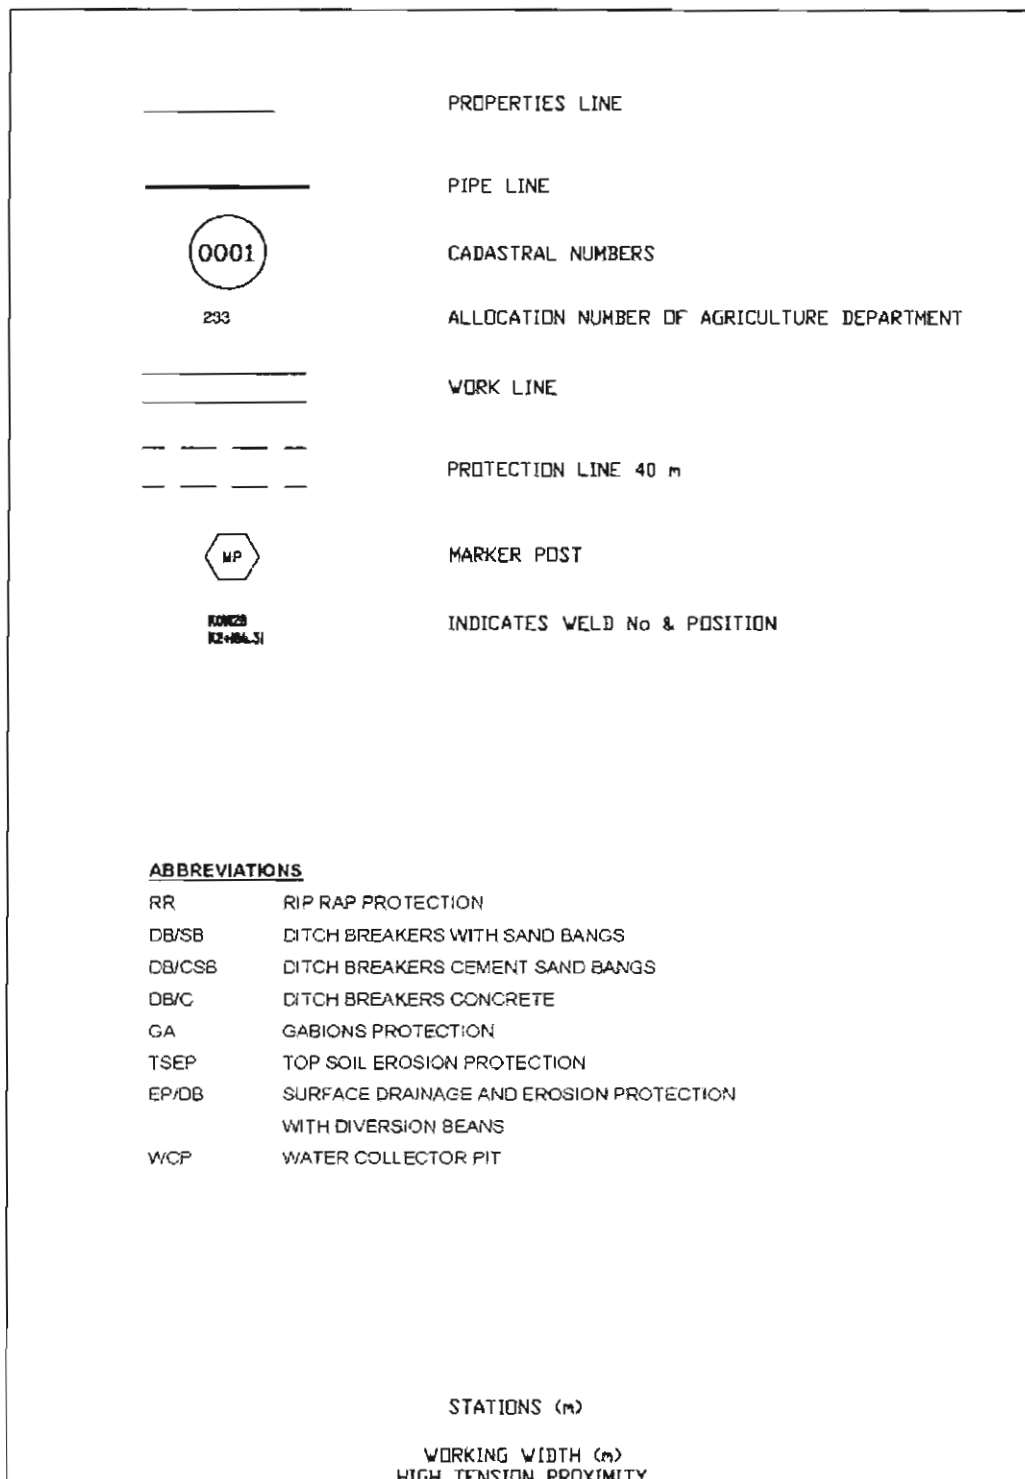

Job Spec. No 499/3  
Revision 0  
Date 05-04-2011  
Page 22/89

APPENDIX B









Job Spec. No 499/3  
 Revision 0  
 Date 05-04-2011  
 Page 26/89

**APPENDIX B – FIG. 4 (example)**

N/N	ABBREVIATIONS	DESCRIPTION
1	ST	SCRAPER TRAP
2	VBL	BALL VALVE
3	VGA (SHO)	GATE VALVE (SHUT OFF)
4	VGA (TH)	GATE VALVE (THROTTLING)
5	VPL	PLUG VALVE
6	GV	GLOBE VALVE
7	TEE/EQ	EQUAL TEE
8	TEE/EQ/B	EQUAL BARRED TEE
9	TEE/RED	REDUCING TEE
10	TEE/R/B	REDUCING BARRED TEE
11	ELB	ELBOW
12	FLG	FLANGE
13	FL/W/N	WELD NOZZLE FLANGE
14	FL/INS	INSULATING FLANGE
15	FL/BLD	BLIND FLANGE
16	GASK	GASKETS
17	INS CO	INSULATING COUPLE
18	INST	INSTRUMENT
19	PG	PRESSURE GAUGE
20	CP	CAP
21	RE/CON	REDUCER CONCENTRIC
22	NIP	NIPPLE
23	NW	NOZZLE WELD
24	VC	VENT CLOSURES
25	CC	CONDENSATE COLLECTOR
26	FB	FIELD BEND
27	HB	HOT BEND
28	SBL	SIDE BEND LEFT
29	SBR	SIDE BEND RIGHT
30	SAG	SAG BEND
31	OB	OVER BEND
32	e.g. ILVA ITALY	ILVA ITALY
33	e.g. IFB ITALY	ITALIAN BUTTWELDING FITTINGS
34	e.g. PR DAN/MARK	BRDR. CHRISTENSENS HANER A/S
35	e.g. ATH. KOR	COMMERCIAL AND INDUSTRIAL ATHENS KORINTH

**Job Spec. No** 499/3  
**Revision** 0  
**Date** 05-04-2011  
**Page** 27/89

**APPENDIX C**



**APPENDIX C - FIG. 1 (example)**

OWNER : HELLENIC GAS TRANSMISSION SYSTEM OPERATOR (DESFA S.A)  
PROJECT : GREEK GAS PIPELINE  
CONTRACT NO. : .....  
SUPERVISION : .....  
CONTRACTOR : .....

**HYDROSTATIC TEST SUMMARY**

LOCATION :  
SECTION :  
TEST SECTION No :  
K POINT REF START : K POINT REF END:  
KM POINT START : KM POINT END :  
TOTAL LENGTH MTRS :  
DATE OF INTERNAL CLEANING :  
DATE OF INTERNAL GAUGING :  
DATE OF WATER FILLING :  
DATE OF STABILIZATION :  
DATE OF AIR INC TEST :  
RESULT :  
DATE OF PS 1 (STRENGTH) :  
RESULT :  
DATE OF PS 2 (STRENGTH) :  
RESULT :  
DATE OF TIGHTNESS TEST :  
FITNESS TEST PRESSURE :  
RESULT :  
COMMENTS :

The above test was conducted in accordance with the latest revised Hydrotest Specifications and procedures as follows :

SPECIFICATION :  
PROCEDURE :

Job Spec. No 499/3  
 Revision 0  
 Date 05-04-2011  
 Page 29/89

**APPENDIX C - FIG. 2 (example)**

**PERMIT FOR PIPELINE WATERFILLING & HYDROTESTING**

OWNER	:: HELLENIC GAS TRANSMISSION SYSTEM OPERATOR (DESFA S.A.)	SPREAD	:
PROJECT	: GREEK GAS PIPELINE	SECTION	:
CONTRACT NO.	: .....	REF. K POINT	:
SUPERVISION	: .....	REF. DWG's	:
CONTRACTOR	: .....	REPORT No	:
		DATE	:
		PAGE	:

PIPELINE SECTION From Km To Km

Before water filling and testing the following points shall be checked :

	SIGN	SIGN	DATE
1. CONSTRUCTION OF THE PIPELINE SECTION COMPLETED	<input type="checkbox"/>	<input type="checkbox"/>	.....
2. MATERIAL CERTIFICATES COMPLETED	<input type="checkbox"/>	<input type="checkbox"/>	.....
3. FIELD INSPECTION REPORTS (form 1-26) CHECKED	<input type="checkbox"/>	<input type="checkbox"/>	.....
4. SECTION LENGTH CHECKED	<input type="checkbox"/>	<input type="checkbox"/>	.....
5. SECTION PIPE SUDDLES CHECKED	<input type="checkbox"/>	<input type="checkbox"/>	.....
6. NUMBER OF GIRTH WELD CHECKED	<input type="checkbox"/>	<input type="checkbox"/>	.....
7. BENDS CHECKED	<input type="checkbox"/>	<input type="checkbox"/>	.....
8. INSULATION FLANGES CHECKED	<input type="checkbox"/>	<input type="checkbox"/>	.....
9. CASING CROSSING CHECKED	<input type="checkbox"/>	<input type="checkbox"/>	.....
10. L.V.S / S.S INSTALLED	<input type="checkbox"/>	<input type="checkbox"/>	.....
11. SUMMARY PIPE LOG COMPLETED AND CHECKED	<input type="checkbox"/>	<input type="checkbox"/>	.....

WATER FILLING IS PERMITTED

CONTRACTOR	OWNER	SUPERVISION
NAME :	NAME :	NAME :
_____	_____	_____
SIGNATURE	SIGNATURE	SIGNATURE
_____	_____	_____
DATE	DATE	DATE
_____	_____	_____

Job Spec. No 499/3  
 Revision 0  
 Date 05-04-2011  
 Page 30/89

**APPENDIX C - FIG. 3 (example)**

OWNER	: HELLENIC GAS TRANSMISSION SYSTEM OPERATOR (DESFA S.A.)	SPREAD	:
PROJECT	: GREEK GAS PIPELINE	SECTION	:
CONTRACT NO.	: .....	REF. K POINT	:
SUPERVISION	: .....	REF. DWGS	:
CONTRACTOR	: .....	REPORT No.	:
		DATE	:
		PAGE	:

PIPELINE SECTION From KM To KM

1. TOTAL LENGTH (including pipes)	:	_____
2. INSULATING FLANGES	:	_____ _____ _____
3. VALVE STATION	:	_____ _____ _____
4. SCRAPER STATION	:	_____ _____ _____
5. TOTAL NUMBER OF JOINTS	:	_____
JOINTS	:	_____
1st joint of the section	:	_____
Last joint of the section	:	_____
6. CATHODIC PROTECTION		
MEASURING POINTS	:	_____
QUALITY LOCATION	:	_____

CONTRACTOR NAME: \_\_\_\_\_

SIGNATURE \_\_\_\_\_


DATE \_\_\_\_\_

SUPERVISION NAME: \_\_\_\_\_

SIGNATURE \_\_\_\_\_

DATE \_\_\_\_\_

Job Spec. No 499/3  
 Revision 0  
 Date 05-04-2011  
 Page 31/89



**APPENDIX C - FIG. 4 (example)**

1. TOTAL NUMBER OF BENDS : \_\_\_\_\_

including HOT BENDS : \_\_\_\_\_

FIELD BENDS : \_\_\_\_\_

\_\_\_\_\_

\_\_\_\_\_

2. TOTAL QUANTITY OF CASING INSTALLED : \_\_\_\_\_

Location of casing (K-points and their lengths):

Location K point		Length
Start	End	

CONTRACTOR NAME: \_\_\_\_\_

SIGNATURE \_\_\_\_\_

DATE \_\_\_\_\_

SUPERVISION NAME : \_\_\_\_\_

SIGNATURE \_\_\_\_\_

DATE \_\_\_\_\_














**APPENDIX C - FIG. 9 (example)**

**PRESSURE TEST REPORT**

**EVALUATION OF TIGHTNESS TEST**

OWNER	: HELLENIC GAS TRANSMISSION SYSTEM OPERATOR (DESFA S.A.)	SPREAD	:
PROJECT	: GREEK GAS PIPELINE	SECTION	:
CONTRACT NO.	: .....	REF. K POINT	:
SUPERVISION	: .....	REF. DWG's	:
CONTRACTOR	: .....	REPORT No	:

PIPELINE SECTION No .....

START FROM : Km ..... END TO : Km .....

K point ..... K point .....

TECHNICAL DATA :

Subsection	1	2	3	4	5	6	
Material							
L (m)							
De (mm)							
S (mm)							
r <sub>i</sub> (mm)							
0.89*r <sub>i</sub> / s * l / L							
Vr <sub>i</sub> (m <sup>3</sup> )							

AIR TESTS :

P<sub>m</sub> = \_\_\_\_\_ bar t<sub>m</sub> = \_\_\_\_\_ C ==> A = \_\_\_\_\_ mm<sup>3</sup> / kg bar

( A is plotted on the Compressibility Factor Chart on page 3 )

$\Delta V (A) / \text{bar} = [ ( 0.89 * r_i / s * L / \Sigma L ) + A ] * \Sigma Vr_i / 1000$


= \_\_\_\_\_ l / bar

TEST RESULTS :

	1	2	3
P <sub>1</sub> - P <sub>2</sub>			
ΔV (A <sub>b</sub> )			
ΔV (A <sub>b</sub> ) / ΔV (A)			

<p><b>FOR CONTRACTOR</b></p> <p>NAME .....</p> <p>SIGNATURE .....</p>	<p><b>FOR SUPERVISION</b></p> <p>NAME .....</p> <p>SIGNATURE .....</p>	<p><b>FOR OWNER</b></p> <p>NAME .....</p> <p>SIGNATURE .....</p>
---	--	--

		<b>APPENDIX C - FIG. 10 (example)</b>				
<b>PRESSURE TEST REPORT EVALUATION OF TIGHTNESS TEST</b>						
OWNER	: HELLENIC GAS TRANSMISSION SYSTEM OPERATOR (DESFA S.A.)	SPREAD	:			
PROJECT	: GREEK GAS PIPELINE	SECTION	:			
CONTRACT NO.	: .....	REF. K POINT	:			
SUPERVISION	: .....	REF. DWG's	:			
CONTRACTOR	: .....	REPORT No	:			
PIPELINE SECTION No .....						
START FROM : Km .....		END TO : Km .....				
K point .....		K point .....				
$P_1$ = pressure immediately before air test $P_2$ = pressure immediately after air test $\Delta V (A_b)$ = measured relieved water volume in kg $\frac{\Delta V (A_b)}{\Delta V (A_b)}$ = air factor						
REMARKS :						
TIGHTNESS TEST						
Maximum allowed deviation $\Delta V( R ) = +$ _____ l / h						
TEST RESULTS :						
	Time	Date	Press. (bar)	Average temperature		C
Began tightness test			$P_1$	$t_1$ : _____	$t_1$ : _____	$t_1$ : _____
Compl. tightness test			$P_2$	$t_2$ : _____	$t_2$ : _____	$t_2$ : _____
			$p$ _____			$\Delta t$ _____
			$V_{r_i}$ ( m <sup>3</sup> )			
Earth covered segments						
Exposed segments						
$\frac{t_1 + t_2}{2}$	=	$\frac{( t_1 \cdot \text{ground} * V_{r_i} \text{ covered} / \Sigma V_{r_i} + t_1 \text{ pipewall} * V_{r_i} \text{ exposed} / \Sigma V_{r_i} )}{2}$				
	+	$\frac{( t_2 \cdot \text{ground} * V_{r_i} \text{ covered} / \Sigma V_{r_i} + t_2 \text{ pipewall} * V_{r_i} \text{ exposed} / \Sigma V_{r_i} )}{2}$				
	=	_____ °C				
$\frac{P_1 + P_2}{2}$	=	_____ bar ==> B _____ mm <sup>3</sup> / kg °C				
FOR CONTRACTOR	FOR SUPERVISION	FOR OWNER				
NAME .....	NAME .....	NAME .....				
.....	.....	.....				
SIGNATURE	SIGNATURE	SIGNATURE				

Job Spec. No 499/3  
Revision 0  
Date 05-04-2011  
Page 38/89



**APPENDIX C - FIG. 11 (example)**

**PRESSURE TEST REPORT  
EVALUATION OF TIGHTNESS TEST**

OWNER	: HELLENIC GAS TRANSMISSION SYSTEM OPERATOR (DESFA S.A.)	SPREAD	:
PROJECT	: GREEK GAS PIPELINE	SECTION	:
CONTRACT NO.	: .....	REF. K POINT	:
SUPERVISION	: .....	REF. DWG's	:
CONTRACTOR	: .....	REPORT No	:

PIPELINE SECTION No .....

START FROM : Km ..... END TO : Km .....  
K point ..... K point .....

$$\Delta V = \{ ( \Sigma * (0.89 * r_i / s * L / \Sigma L - A) * V (A_b) / V (A) * (p_1 - p_2) - 8 * t (1m) - t (2m) ) \} + V r_i / 1000 = \text{.....} l$$

Test time h = ..... hours  $\Delta V ( R ) = \Delta V / h = \text{.....} l / h$

( B is plotted on the Expansion Factor Chart on page 4 of 4 )

REMARKS :

FOR CONTRACTOR

FOR SUPERVISION

FOR OWNER

NAME .....

NAME .....

NAME .....


SIGNATURE

SIGNATURE

SIGNATURE

Job Spec. No 499/3  
Revision 0  
Date 05-04-2011  
Page 39/89

APPENDIX C – FIG. 12

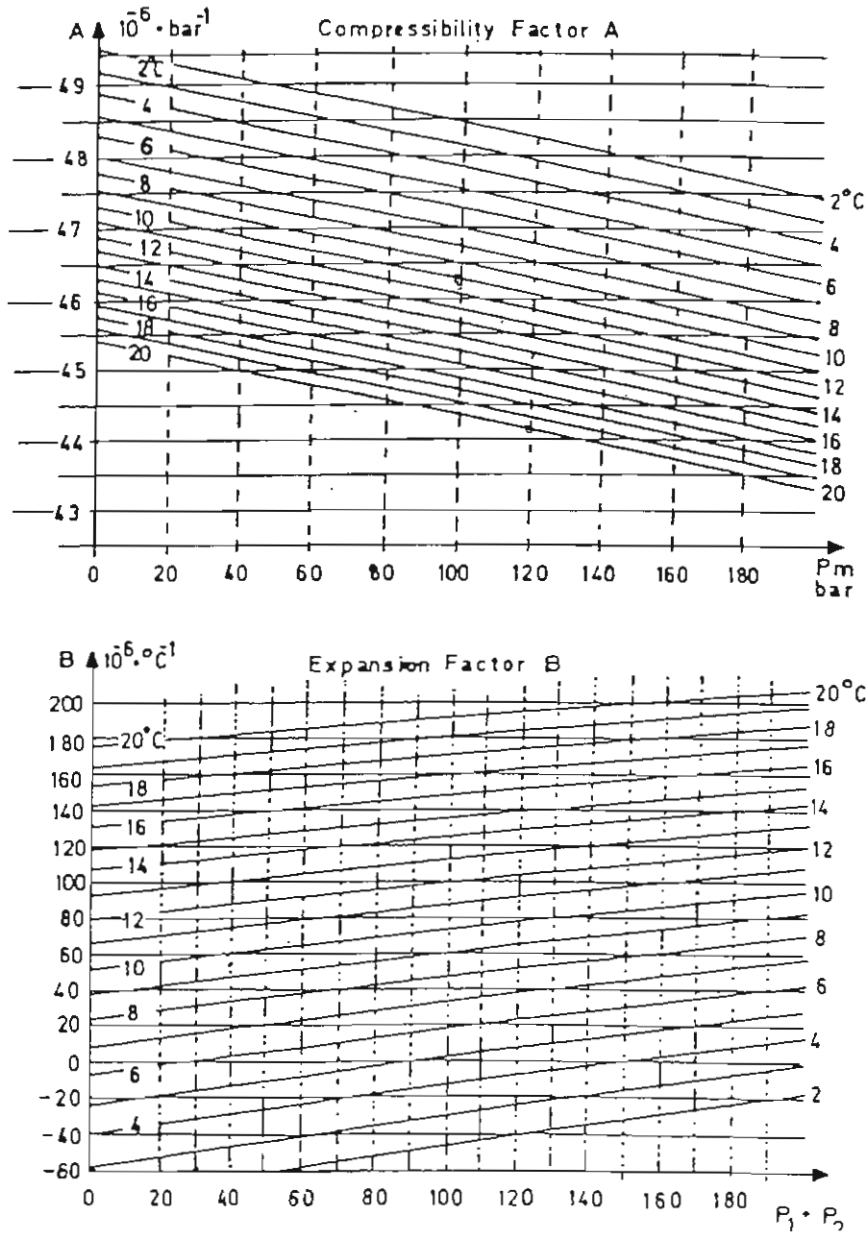

Job Spec. No 499/3  
Revision 0  
Date 05-04-2011  
Page 40/89

**APPENDIX C - FIG. 13 (example)**

**PRESSURE TEST REPORT  
PRESSURE V<sup>S</sup> VOLUME**

OWNER	: HELLENIC GAS TRANSMISSION SYSTEM OPERATOR (DESFA S.A)	SPREAD	:
PROJECT	: GREEK GAS PIPELINE	SECTION	:
CONTRACT NO.	: .....	REF. K. POINT	:
SUPERVISION	: .....	REF DWG's	:
CONTRACTOR	: .....	REPORT No.	:
		DATE	:
		PAGE	:

DATE : 22.09.1993

PROJECT ..... : Greece Gas  
Diameter mm..... : 914.40  
Total Length m..... : 7104.00  
Volume cbm..... : 4420.09  
RI / S..... : 36.92

Pipe Yield Strength.....(N / mm<sup>2</sup>) : 448  
100% K min. Wallthickness..... : 108.77  
Constant Factor ( .89)..... : 0.89  
Water Temperature Deg. C ..... : 20.00

Pressure barg	Total Vol. Litre	Delta Vol. Litre/bar	A Value
5.00	1730.24	346.05	45.44
10.00	3459.33	345.82	45.38
15.00	5187.29	345.59	45.33
20.00	6914.08	345.36	45.28
25.00	8639.74	345.13	45.23
30.00	10364.26	344.90	45.18
35.00	12087.64	344.68	45.12
40.00	13809.87	344.45	45.07
45.00	15530.96	344.22	45.02
50.00	17250.90	343.99	44.97
55.00	18969.71	343.76	44.92
60.00	20687.37	343.53	44.87
65.00	22403.88	343.30	44.81
70.00	24119.25	343.07	44.76
75.00	25823.48	342.85	44.71
80.00	27546.57	342.62	44.66
85.00	29258.51	342.39	44.61
90.00	30969.31	342.16	44.56
95.00	32678.97	341.93	44.50
100.00	34387.48	341.70	44.45
105.00	36094.85	341.47	44.40
110.00	37801.08	341.25	44.35
115.00	39506.16	341.02	44.30
120.00	41210.10	340.79	44.25
125.00	42912.90	340.56	44.19
130.00	44614.55	340.33	44.14
135.00	46315.06	340.10	44.09



Job Spec. No 499/3  
Revision 0  
Date 05-04-2011  
Page 41/89

APPENDIX C - FIG. 14 (example)

TIGHTNESS CALCULATION

OWNER	: HELLENIC GAS TRANSMISSION SYSTEM OPERATOR (DESFA S.A)	SPREAD	:
PROJECT	: GREEK GAS PIPELINE	SECTION	:
CONTRACT NO.	: .....	REF. K. POINT	:
SUPERVISION	: .....	REF DWG's	:
CONTRACTOR	: .....	REPORT No.	:
		DATE	:
		PAGE	:

DATE : 22.09.1993

PROJECT ..... : Greece Gas  
OWNER ..... : DESFA  
LINE SECTION ..... : 36 - 1  
FILE NAME ..... : 36 - 2  
FILE DIRECTORY ..... : C : \ DESFA \ TEST \

PIPELINE DATA :  
LENGTH .....(meter) : 7104.00  
DIAMETER .....(inch NPS) : 36  
PIPE YIELD STRENGTH....(N / mm<sup>2</sup>) : 448

TIGHTNESS CALCULATION :

First Block Number	:	22
Last Block Number	:	70
Calculation Period ( H )	:	24
Pressure Start	:	111.166
Pressure End	:	111.313
Delta Pressure	:	+ 0.147
Temperature Start ( °C )	:	19.73
Temperature End ( °C )	:	19.86
Delta Temperature ( °C )	:	+ 0.13
Actual Volume Change	:	- 2.15 Litres / Hour
Permissible Volume Change	:	4.00 Litres / Hour

The Test is Acceptable !!!!!



Job Spec. No 499/3  
Revision 0  
Date 05-04-2011  
Page 43/89

(example)

DESFA		APPENDIX C - FIG. 16					
Hellenic Gas Transmission System Operator		PRESSURE TEST REPORT					
		HYDROSTATIC STRENGTH TEST					
OWNER	: HELLENIC GAS TRANSMISSION SYSTEM OPERATOR (DESFA S.A)	SPREAD	:				
PROJECT	: GREEK GAS PIPELINE	SECTION	:				
CONTRACT NO.	: .....	REF. K. POINT	:				
SUPERVISION	: .....	REF DWG's	:				
CONTRACTOR	: .....	REPORT No.	:				
		DATE	:				
		PAGE	:				
DATE	: 22.09.1993						
PROJECT	: Greece Gas						
OWNER	: DESFA						
LINE SECTION	: 36 - 1						
FILE NAME	: 36 - 2						
FILE DIRECTORY	: C : \ DESFA \ TEST \						
PIPELINE DATA	:						
LENGTH	: (meter) : 7104.00						
DIAMETER	: DN 900						
PIPE YIELD STRENGTH	: (N / mm <sup>2</sup> ) : 448						
HYDROSTATIC STRENGTH TEST							
NO.	PRESS bar	FLOW l/min	VOLUME litre	DP/DT bar/m	DV/DP l/bar	Σ DDV litre	TIME HH:MM:SS
1	19.69	478.2	3140	1.37	349.80	7.9	15:30:00
2	21.01	467.8	3612	1.26	370.35	-0.3	15:31:00
3	22.37	480.2	4102	1.32	363.12	-0.3	15:32:00
4	23.71	488.5	4588	1.32	369.35	2.0	15:33:00
5	25.07	481.0	5072	1.25	385.32	1.6	15:34:00
6	26.41	487.9	5557	1.40	349.31	2.7	15:35:00
7	27.72	395.7	6024	1.65	239.89	-1.1	15:36:00
8	28.88	391.3	6421	0.94	417.97	19.0	15:37:00
9	29.98	398.4	6817	0.83	478.79	19.4	15:38:00
10	31.08	394.2	7212	1.26	312.43	-18.0	15:39:00
11	32.18	396.1	7607	1.25	317.82	-17.5	15:40:00
12	33.27	395.7	8003	1.07	370.21	-11.2	15:41:00
13	34.36	399.0	8399	0.98	407.23	-5.3	15:42:00
14	35.45	395.5	8796	1.08	364.97	2.7	15:43:00
15	36.53	401.2	9195	1.20	333.64	11.0	15:44:00
16	37.64	397.6	9592	1.11	356.55	13.8	15:45:00
17	38.68	382.4	9974	1.05	343.82	22.2	15:46:00
18	39.68	368.4	10334	1.04	352.61	25.0	15:47:00
19	40.70	371.7	10709	1.07	347.78	34.9	15:48:00
20	41.75	411.1	11106	1.04	395.58	56.1	15:49:00
21	42.85	415.3	11515	1.04	358.65	73.6	15:50:00
22	43.93	418.4	11927	1.16	366.03	97.2	15:51:00
23	45.02	422.6	12344	1.14	395.38	127.4	15:52:00
24	46.10	422.6	12765	1.07	389.97	161.3	15:53:00
25	47.16	422.6	13183	1.08	374.57	198.9	15:54:00
26	48.37	424.6	13658	1.13	294.88	241.5	15:55:00
27	49.48	426.4	14086	0.99	341.98	274.7	15:56:00
28	51.65	436.7	14519	0.92	311.6	311.6	15:57:00
29	50.59	449.3	14953	1.14	367.5	367.5	15:58:00
30	52.76	455.4	15409	1.22	429.1	429.1	15:59:00



DESFA		APPENDIX C - FIG. 18 (example)				
Hellenic Gas Transmission System Operator						
OWNER	: HELLENIC GAS TRANSMISSION SYSTEM OPERATOR (DESFA S.A)	SPREAD	:			
PROJECT	: GREEK GAS PIPELINE	SECTION	:			
CONTRACT NO.	: .....	REF. K. POINT	:			
SUPERVISION	: .....	REF DWG's	:			
CONTRACTOR	: .....	REPORT No.	:			
		DATE	:			
		PAGE	:			
PROJECT ..... : Greece Gas						
OWNER ..... : DESFA						
LINE SECTION ..... : 36 - 1						
FILE NAME ..... : 36 - 2						
FILE DIRECTORY ..... : C : \ DESFA \ TEST \						
PIPELINE DATA :						
LENGTH .....(meter) : 7104.00						
DIAMETER ..... : DN 900						
PIPE YIELD STRENGTH....(N / mm <sup>2</sup> ) : 448						
<b>HYDROSTATIC STRENGTH TEST</b>						
NO.	PRESSURE bar	D - PRESS bar	TEMP 1 °C	TEMP 2 °C	TIME HH:MM:SS	DATE DD.MM.YYYY
1	111.399	111.399	22.81		21:30:00	20:09:1993
2	111.417	0.018	24.07		22:00:00	20:09:1993
3	111.387	-0.031	24.14		22:30:00	20:09:1993
4	111.350	-0.037	24.08		23:00:00	20:09:1993
5	111.294	-0.056	23.99		23:30:00	20:09:1993
6	111.310	0.016	23.93		0:00:00	21:09:1993
7	111.259	-0.050	23.86		0:30:00	21:09:1993
8	111.248	-0.011	23.78		1:00:00	21:09:1993
9	111.231	-0.017	23.70		1:30:00	21:09:1993
10	111.224	-0.007	23.63		2:00:00	21:09:1993
11	111.207	-0.017	23.54		2:30:00	21:09:1993
12	111.190	-0.017	23.45		3:00:00	21:09:1993
13	111.186	-0.004	23.33		3:30:00	21:09:1993
14	111.190	0.004	23.12		4:00:00	21:09:1993
15	111.177	-0.012	23.23		4:30:00	21:09:1993
16	111.177	0.000	23.01		5:00:00	21:09:1993
17	111.177	0.000	22.92		5:30:00	21:09:1993
18	111.175	-0.002	22.75		6:00:00	21:09:1993
19	111.174	-0.002	22.67		6:30:00	21:09:1993
20	111.173	-0.001	22.59		7:00:00	21:09:1993
21	111.181	-0.001	22.47		7:30:00	21:09:1993
22	111.166	0.009	22.36		8:00:00	21:09:1993
23	111.162	-0.015	22.31		8:30:00	21:09:1993
24	111.163	-0.005	22.28		9:00:00	21:09:1993
25	111.159	0.001	22.30		9:30:00	21:09:1993
26	111.158	-0.004	22.50		10:00:00	21:09:1993
27	111.136	-0.001	23.95		10:30:00	21:09:1993
28	111.170	-0.022	24.90		11:00:00	21:09:1993
29	111.133	0.034	26.52		11:30:00	21:09:1993
30	111.130	-0.037	28.75		12:00:00	21:09:1993



Job Spec. No 499/3  
 Revision 0  
 Date 05-04-2011  
 Page 47/89



**APPENDIX C - FIG. 20 (example)**

**PRESSURE TEST REPORT  
 FAULT REPORT**


OWNER	: HELLENIC GAS TRANSMISSION SYSTEM OPERATOR (DESFA S.A.)	SPREAD	:
PROJECT	: GREEK GAS PIPELINE	SECTION	:
CONTRACT NO.	: .....	REF. K POINT	:
SUPERVISION	: .....	REF. DWG's	:
CONTRACTOR	: .....	REPORT No	:

PIPELINE SECTION No .....	
START FROM : Km .....	END TO : Km .....
K point .....	K point .....
Fault Log	
Discovered, during :	Waterfalling
	Strength test
	Tightness test
Pressure at leak/break: bar	pipe temp.: °C
Fault detected time:	Date:
Fault located time:	Date:
Fault repaired time:	Date:
Comments: (damages/repair arrangements etc.)	

<b>FOR CONTRACTOR</b>	<b>FOR SUPERVISION</b>	<b>FOR OWNER</b>
NAME .....	NAME .....	NAME .....
.....	.....	.....
SIGNATURE	SIGNATURE	SIGNATURE

Job Spec. No 499/3  
Revision 0  
Date 05-04-2011  
Page 48/89


(example)

	<b>APPENDIX C - FIG. 21</b>	
<b>PRESSURE TEST REPORT FAULT REPORT</b>		
OWNER :	HELLENIC GAS TRANSMISSION SYSTEM OPERATOR (DESFA S.A.)	SPREAD :
PROJECT :	GREEK GAS PIPELINE	SECTION :
CONTRACT NO. :	.....	REF. K POINT :
SUPERVISION :	.....	REF. DWG's :
CONTRACTOR :	.....	REPORT No :
PIPELINE SECTION No .....		
START FROM : Km .....		END TO : Km .....
K point .....		K point .....
Length of section:	m	
Volume of section:	m <sup>3</sup>	
Fault Data:		
Location: chain. no.		
Type: Leak --	Rate of leak	m <sup>3</sup> /h
Break --		
Position: Field weld	--	
Pipe seam	--	
Body of pipe	--	
Valve	--	
Temporary installations	--	
Others	--	
Comments:		
FOR CONTRACTOR	FOR SUPERVISION	FOR OWNER
NAME .....	NAME .....	NAME .....
.....	.....	.....
SIGNATURE	SIGNATURE	SIGNATURE



Job Spec. No 499/3  
Revision 0  
Date 05-04-2011  
Page 49/89


(example)

	<b>APPENDIX C - FIG. 22</b>						
<b>PRESSURE TEST REPORT</b>							
<b>REPORT ON HYDROTESTING SECTION, CROSSING ETC</b>							
OWNER :	HELLENIC GAS TRANSMISSION SYSTEM OPERATOR (DESFA S.A.)	SPREAD :					
PROJECT :	GREEK GAS PIPELINE	SECTION :					
CONTRACT NO. :	.....	REF. K. POINT :					
SUPERVISION :	.....	REF. DRWG's :					
CONTRACTOR :	.....	REPORT No. :					
UNIT..... km.....		K point.....					
<b>MATERIAL COMPONENTS</b>							
S1	Dxt	Unit	Amount	S1	Dxt	Unit	Amount
Volume of section (unit)..... m <sup>3</sup>							
Process of testing							
Date/ time	Ambient air temperature °C	Temperature in the unit °C	Pressure			Remarks	
			P1 bar	P2 bar	P3 bar		
FOR CONTRACTOR		FOR SUPERVISION			FOR EMPLOYER		
NAME .....		NAME .....			NAME .....		
SIGNATURE		SIGNATURE			SIGNATURE		




Job Spec. No 499/3  
Revision 0  
Date 05-04-2011  
Page 51/89

(example)

	<b>APPENDIX C - FIG. 24</b>	sheet 1/3		
<b>PRESSURE TEST REPORT SUMMARY</b>				
OWNER :	HELLENIC GAS TRANSMISSION SYSTEM OPERATOR (DESFA S.A.)	SPREAD :		
PROJECT :	GREEK GAS PIPELINE	SECTION :		
CONTRACT NO. :	.....	REF. K POINT :		
SUPERVISION :	.....	REF. DWG's :		
CONTRACTOR :	.....	REPORT No :		
PIPELINE SECTION No .....				
START FROM : Km .....		END TO : Km .....		
K point .....		K point .....		
Length of section:	m			
Volume of section:	m <sup>3</sup>			
PART LIST				
Type	Manufacture	Material	Dimension	Length
Equipment and Instruments:				
Type	Manufacture	Chainage		
TEST PRESSURE	Level (m)	Pressure (bar)	Maximum stress level in min wall (%SMYS)	
Down-stream point				
FOR CONTRACTOR	FOR SUPERVISION	FOR OWNER		
NAME .....	NAME .....	NAME .....		
.....	.....	.....		
SIGNATURE	SIGNATURE	SIGNATURE		


Job Spec. No 499/3  
Revision 0  
Date 05-04-2011  
Page 52/89

(example)

	<p><b>APPENDIX C - FIG. 25</b></p>	<p>sheet 2/3</p>	
<p><b>PRESSURE TEST REPORT SUMMARY</b></p>			
<p><b>OWNER</b> : HELLENIC GAS TRANSMISSION SYSTEM OPERATOR (DESFA S.A.)</p> <p><b>PROJECT</b> : GREEK GAS PIPELINE</p> <p><b>CONTRACT NO.</b> : .....</p> <p><b>SUPERVISION</b> : .....</p> <p><b>CONTRACTOR</b> : .....</p>	<p><b>SPREAD</b> :</p> <p><b>SECTION</b> :</p> <p><b>REF. K POINT</b> :</p> <p><b>REF. DWG's</b> :</p> <p><b>REPORT No</b> :</p>		
<p>PIPELINE SECTION No .....</p>			
<p>START FROM : Km ..... END TO : Km .....</p> <p style="margin-left: 100px;">K point ..... K point .....</p>			
Highest point: .....			
Lowest point: .....			
Upstream point: .....			
FILLING WATER: pH: .....			
Temp.: .....			
Aircontent: .....			
TEST LOG:			
	Time	Date	Related test reports
Began filling			
Completed filling			
Began pressuring			
Completed pressuring			
Began depressuring			
Completed depressuring			
Began pressuring			
Completed pressuring			
Completed tightness test			
Began dewatering			
Completed dewatering			
<p><b>FOR CONTRACTOR</b></p> <p><b>NAME</b> .....</p> <p>.....</p> <p><b>SIGNATURE</b></p>	<p><b>FOR SUPERVISION</b></p> <p><b>NAME</b> .....</p> <p>.....</p> <p><b>SIGNATURE</b></p>	<p><b>FOR OWNER</b></p> <p><b>NAME</b> .....</p> <p>.....</p> <p><b>SIGNATURE</b></p>	

Job Spec. No 499/3  
 Revision 0  
 Date 05-04-2011  
 Page 53/89


(example)

	<p><b>APPENDIX C - FIG. 26</b></p>	<p>sheet 3/3</p>						
<p><b>PRESSURE TEST REPORT SUMMARY</b></p>								
<p>OWNER : HELLENIC GAS TRANSMISSION SYSTEM OPERATOR (DESFA S.A.)</p> <p>PROJECT : GREEK GAS PIPELINE</p> <p>CONTRACT NO. : .....</p> <p>SUPERVISION : .....</p> <p>CONTRACTOR : .....</p>	<p>SPREAD :</p> <p>SECTION :</p> <p>REF. K POINT :</p> <p>REF. DWG's :</p> <p>REPORT No :</p>							
<p>PIPELINE SECTION No .....</p>								
<p>START FROM : Km ..... END TO : Km .....</p> <p style="margin-left: 100px;">K point ..... K point .....</p>								
<p>TIGHTNESS TEST:</p> <table style="width: 100%; border-collapse: collapse;"> <tr> <td style="width: 60%;">Max allowed volume deviation:</td> <td style="width: 40%; text-align: right;">lt/h</td> </tr> <tr> <td>Calculated volume deviation:</td> <td style="text-align: right;">lt/h</td> </tr> <tr> <td>Duration of tightness test:</td> <td style="text-align: right;">lt/h</td> </tr> </table>			Max allowed volume deviation:	lt/h	Calculated volume deviation:	lt/h	Duration of tightness test:	lt/h
Max allowed volume deviation:	lt/h							
Calculated volume deviation:	lt/h							
Duration of tightness test:	lt/h							
<p>REMARKS:</p> <div style="border: 1px solid black; height: 100px; width: 100%;"></div>								
<p>FOR CONTRACTOR</p> <p>NAME .....</p> <p>.....</p> <p>SIGNATURE</p>	<p>FOR SUPERVISION</p> <p>NAME .....</p> <p>.....</p> <p>SIGNATURE</p>	<p>FOR OWNER</p> <p>NAME .....</p> <p>.....</p> <p>SIGNATURE</p>						



Job Spec. No 499/3  
Revision 0  
Date 05-04-2011  
Page 55/89

APPENDIX C – FIG. 28

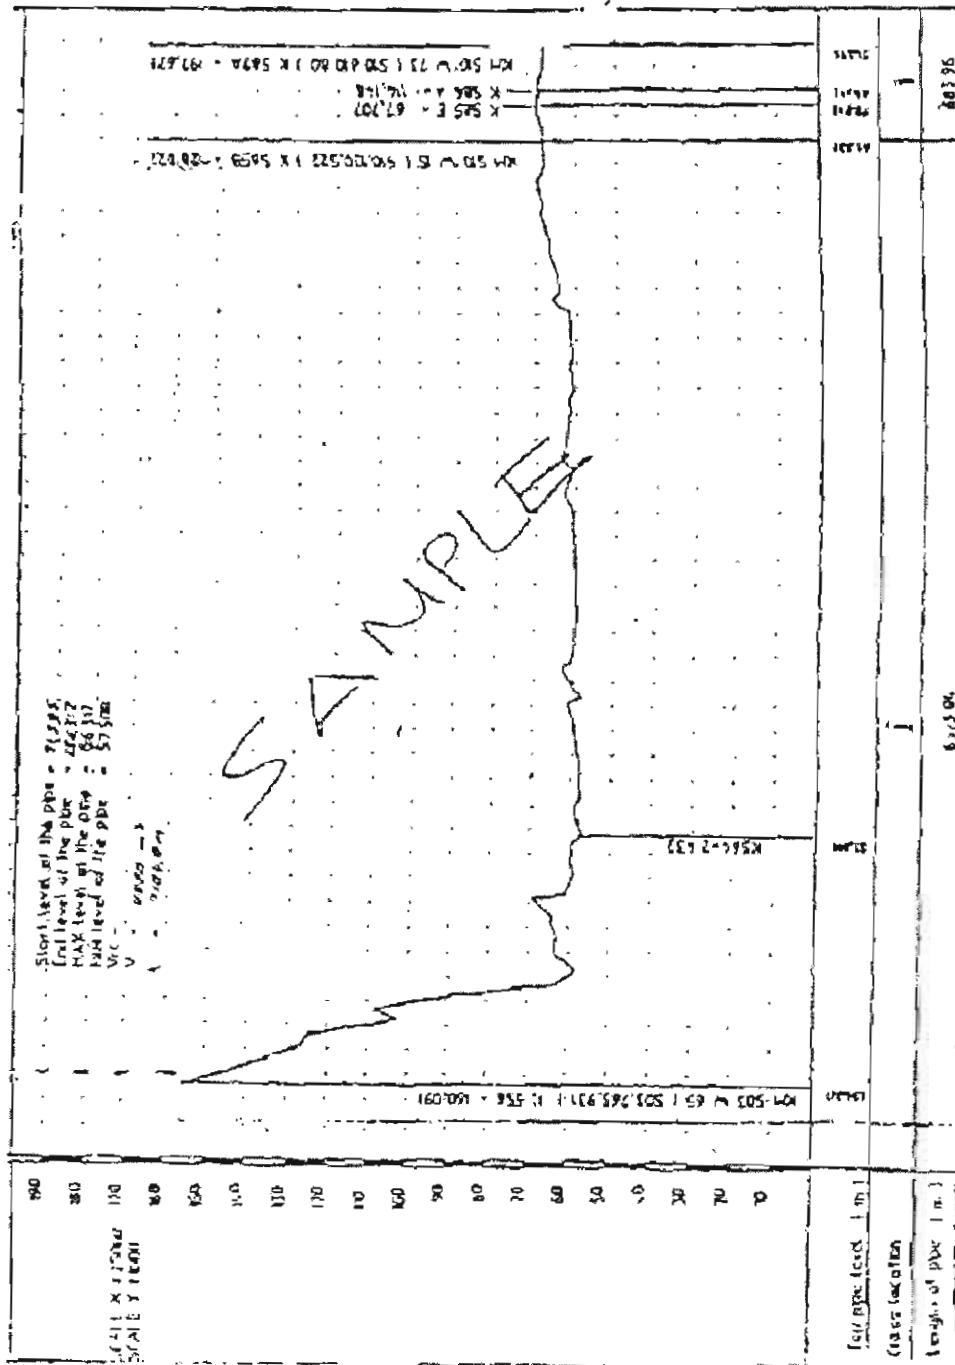

Job Spec. No 499/3  
Revision 0  
Date 05-04-2011  
Page 56/89

APPENDIX C – FIG. 29





Job Spec. No 499/3  
 Revision 0  
 Date 05-04-2011  
 Page 57/89

(example)

OWNER		SPREAD	
: HELLENIC GAS TRANSMISSION SYSTEM OPERATOR (DESFA S.A.)		:	
PROJECT		SECTION	
: GREEK GAS PIPELINE		:	
CONTRACT NO.		REF. K POINT	
: .....		:	
SUPERVISION		REF. DWG's	
: .....		:	
CONTRACTOR		REPORT No.	
: .....		:	

Section No _____	Length L= _____
from K.p. _____	to K.p. _____

Equipment and measuring devices used for drying :

Date	Time	Pigs launched (No)	Pigs received (No)	Condition of pigs received	Receiver		Dew point at the inlet location (°C)	Remarks
					P (bar)	dew point (°C)		

<b>FOR CONTRACTOR</b> NAME ..... ..... SIGNATURE	<b>FOR SUPERVISION</b> NAME ..... ..... SIGNATURE	<b>FOR OWNER</b> NAME ..... ..... SIGNATURE
---	--	--


**Job Spec. No** 499/3  
**Revision** 0  
**Date** 05-04-2011  
**Page** 58/89

**APPENDIX D**



Job Spec. No 499/3  
Revision 0  
Date 05-04-2011  
Page 60/89

(example)

		<p><b>APPENDIX D - FIG. 2</b></p> <p><b>WELDING LOG BOOK</b></p>					
OWNER :	HELLENIC GAS TRANSMISSION SYSTEM OPERATOR (DESFA S.A.)	SPREAD :	:				
PROJECT :	GREEK GAS PIPELINE	SECTION :	:				
CONTRACT NO. :	.....	REF K. POINT :	:				
SUPERVISION :	.....	REF DWG'S :	:				
CONTRACTOR :	.....	REPORT No. :	:				
		DATE :	:				
		PAGE :	:				
WELDING PROCEDURES : _____							
_____							
_____							
	pass and direction	filler metal	dia.				
• assembly welds	root pass _____						
	filler pass _____						
	cap pass _____						
• Tie - ins	root pass _____						
	filler pass _____						
	cap pass _____						
NON - DESTRUCTIVE TEST OF CIRCUMFERENTIAL WELDS							
TOTAL NUMBER OF CIRCUMFERENTIAL WELDS IN THE COMPLETED PIPING :							
	radiographic tests		results				
numbers of welds tested/dia	_____ = 100 %	additional ultrasonic tests conducted	total number of welds				
_____	_____ = %	on _____ welds	_____ = 100 %				
_____	_____ = %	= _____ %	numbers of welds tested by non-destructive methods				
_____	_____ = %	of certificates for results	_____ = 100 %				
WELDERS :							
No.	Full Name	Ref. No.	Welder Qualification to	Welding Procedure	Welded		Pass(es) on which employed
					From	To	
REMARKS :							
_____							
CONTRACTOR				SUPERVISION			
NAME				NAME			
SIGNATURE				SIGNATURE			



Job Spec. No 499/3  
Revision 0  
Date 05-04-2011  
Page 62/89

(example)


APPENDIX D - FIG. 4

VOLUMES FOR :

- WELDING PROCEDURES
- WELDING PROCEDURES SPECIFICATIONS (W.P.S)

Job Spec. No 499/3  
 Revision 0  
 Date 05-04-2011  
 Page 63/89

(example)

		<b>APPENDIX D - FIG. 5</b>	
<b><u>TIE - IN REPORT</u></b>			
OWNER	: HELLENIC GAS TRANSMISSION SYSTEM OPERATOR (DESFA S.A.)	SPREAD	:
PROJECT	: GREEK GAS PIPELINE	SECTION	:
CONTRACT NO.	: .....	REF. K. POINT	:
SUPERVISION	: .....	REF. DWG's	:
CONTRACTOR	: .....	REPORT No.	:
		DATE	:
		PAGE	:

WELD NO.				
DATE OF WELDING				
CHAINAGE				
WELDER'S NO.				
PROCEDURE				
PIPE NO.				
PIPE LENGTH (a)				
PIPE DIA x WALL TH.				
COATING				
INFORMATION ABOUT CUT OFF PIPE PIECES				

SKETCH

WELD NO.	INSPECTION			REMARKS : ( Excavation, Dewatering, Tie-in Operation, Welding)
	VISUAL	R.I.	U.I	


CONTRACTOR NAME :	SUPERVISION NAME :
_____	_____
SIGNATURE	SIGNATURE





Job Spec. No 499/3  
Revision 0  
Date 05-04-2011  
Page 65/89

(example)



**DESFA**  
Hellenic Gas Transmission System Operator

**APPENDIX D - FIG. 7**

**ULTRASONIC EXAMINATION REPORT**

<p><b>OWNER :</b> HELLENIC GAS TRANSMISSION SYSTEM OPERATOR (DESFA S.A.)</p> <p><b>PROJECT :</b> GREEK GAS PIPELINE</p> <p><b>CONTRACT NO. :</b> .....</p> <p><b>SUPERVISION :</b> .....</p> <p><b>CONTRACTOR :</b> .....</p>	<p><b>SPREAD :</b></p> <p><b>SECTION :</b></p> <p><b>REF. K POINT :</b></p> <p><b>REF. DWG' s :</b></p> <p><b>REPORT No. :</b></p> <p><b>DATE :</b></p> <p><b>PAGE :</b></p>
---	--

DIAMETER :	THICKNESS :	STEEL GRADE :	TYPE OF FLAW DETECTOR :	TYPE OF REFERENCE :	ANGLE OF RAY ONPUT :
OPERATING FREQUENCY :		TYPE OF CONTACT LIQUID :		LEVEL OF INSPECTION SENSITIVITY	
WELDING LOG. NO.	PIPE NO.	WELD JOINT NO.	WELDE R NO.	Coordinates and description of discovered defects :	
				Final Conclusion :	
				Acceptable	- OK
				Repair	- R
				To be cut out	- CO

**REMARKS :**

**CONTRACTOR NAME** \_\_\_\_\_


**SIGNATURE** \_\_\_\_\_

**SUPERVISION NAME** \_\_\_\_\_

**SIGNATURE** \_\_\_\_\_

Job Spec. No 499/3  
Revision 0  
Date 05-04-2011  
Page 66/89

(example)



**APPENDIX D - FIG. 8**

**MAGNETIC PARTICLES INSPECTION REPORT**

<p><b>OWNER :</b> HELLENIC GAS TRANSMISSION SYSTEM OPERATOR (DESFA S.A.)</p> <p><b>PROJECT :</b> GREEK GAS PIPELINE</p> <p><b>CONTRACT NO. :</b> .....</p> <p><b>SUPERVISION :</b> .....</p> <p><b>CONTRACTOR :</b> .....</p>	<p><b>SPREAD :</b></p> <p><b>SECTION :</b></p> <p><b>REF. K POINT :</b></p> <p><b>REF. DWG' s :</b></p> <p><b>REPORT No. :</b></p> <p><b>DATE :</b></p> <p><b>PAGE :</b></p>	<p><b>DIAMETER :</b> _____</p> <p><b>THICKNESS :</b> _____</p> <p><b>STEEL GRADE :</b> _____</p> <p><b>CONTRAST COATING :</b> _____</p> <p><b>MAGNETIZING FORK :</b> _____</p>
---	--	--

WELDING LOG. NO.	PIPE NO.	WELD JOINT NO.	WELDE R NO.	Coordinates and description of discovered defects :	Final Conclusion :
					Acceptable - OK
					Repair - R
					To be cut out - CO

**REMARKS :** \_\_\_\_\_

**CONTRACTOR NAME** \_\_\_\_\_


**SIGNATURE** \_\_\_\_\_

**SUPERVISION NAME** \_\_\_\_\_

**SIGNATURE** \_\_\_\_\_

Job Spec. No 499/3  
 Revision 0  
 Date 05-04-2011  
 Page 67/89

(example)



**APPENDIX D - FIG. 9**

**LIQUID PENETRANT INSPECTION REPORT**

**OWNER :** HELLENIC GAS TRANSMISSION SYSTEM OPERATOR (DESFA S.A.)

**PROJECT :** GREEK GAS PIPELINE

**CONTRACT NO. :** .....

**SUPERVISION :** .....

**CONTRACTOR :** .....

**SPREAD :** .....

**SECTION :** .....

**REF. K POINT :** .....

**REF. DWG' s :** .....

**REPORT No. :** .....

**DATE :** .....

**PAGE :** .....

DIAMETER :	THICKNESS :	STEEL GRADE :			
MEANS OF INSPECTION			Removed Fluid		
			Penetrant		
			Developer		
WELDING LOG. NO.	PIPE NO.	WELD JOINT NO.	WELDE R NO.	Coordinates and description of discovered defects :	Final Conclusion :
					Acceptable - OK
					Repair - R
					To be cut out - CO
REMARKS :					

**CONTRACTOR NAME** \_\_\_\_\_

**SIGNATURE** \_\_\_\_\_

**SUPERVISION NAME** \_\_\_\_\_

**SIGNATURE** \_\_\_\_\_

**Job Spec. No** 499/3  
**Revision** 0  
**Date** 05-04-2011  
**Page** 68/89

**APPENDIX E**








Job Spec. No 499/3  
 Revision 0  
 Date 05-04-2011  
 Page 72/89

(example)

	<b>APPENDIX E - FIG. 4</b>					
<b><u>CATHODIC PROTECTION</u></b>						
<b>CHECK AND CALIBRATION OF POLARIZATION PROBES REPORT ( POST TYPE K9 )</b>						
OWNER	: HELLENIC GAS TRANSMISSION SYSTEM OPERATOR (DESFA S.A.)	SPREAD	:			
PROJECT	: GREEK GAS PIPELINE	SECTION	:			
CONTRACT NO.	: .....	REF. K POINT	:			
SUPERVISION	: .....	REF. DWG' s	:			
CONTRACTOR	: .....	REPORT No.	:			
		DATE	:			
		PAGE	:			

CHAINAGE							
DATE							
CABLE TEST	TO CALOMEL ELECTRODE (Ω)						
	TO STEEL PLATE (Ω)						
CABLE CONNECTION WITH STEEL PLATE (Ω)							
INSULATION TEST	INSULATING CIRCLE (mV)						
	COUNTER TEST (mV)						
REFERENCE							
ELECTRODE TEST (mV)							
DIAPHRAGM TEST (mV)							
DEVIATION %							
REFERENCE ELECTRODE CALIBRATION (mV)							
APPROVAL YES / NO							
REMARKS :							

CONTRACTOR	SUPERVISION
NAME : _____	NAME : _____



**Job Spec. No** 499/3  
**Revision** 0  
**Date** 05-04-2011  
**Page** 73/89

(example)



**APPENDIX E - FIG. 5**

**CATHODIC PROTECTION  
 SOIL RESISTIVITY MEASUREMENTS**

<b>OWNER</b>	: HELLENIC GAS TRANSMISSION SYSTEM OPERATOR (DESFA S.A.)	<b>SPREAD</b>	:
<b>PROJECT</b>	: GREEK GAS PIPELINE	<b>SECTION</b>	:
<b>CONTRACT NO.</b>	: .....	<b>REF. K. POINT</b>	:
<b>SUPERVISION</b>	: .....	<b>LOCATION (km)</b>	:
<b>CONTRACTOR</b>	: .....	<b>REF. DWG's</b>	:
		<b>REPORT No.</b>	:
		<b>DATE</b>	:
		<b>PAGE</b>	:

MAIN FORMULA FOR SOIL RESISTIVITY							
$p = 2 n . a . R .$ (only if $a = 6$ )							
REF. K POINT	KM	DISTANCE BETWEEN ELECTRODES a (a)	FORMULA FACTOR f $f = 2n.a$	READING OF INSTRUMENT ( $\Omega$ ha)	INSTRUMENT FACTOR	RESISTANCE R ( $\Omega$ ha)	SOIL RESISTIVITY $p.f.R$ $\rho$ ( $\Omega$ h/s)
AVERAGE VALUE							
AVERAGE VALUE							
AVERAGE VALUE							
INSTRUMENT :							
SERIAL No :							
CERT. No. :							
REMARKS :							

<b>CONTRACTOR</b>	<b>OWNER</b>	<b>SUPERVISION</b>
<b>NAME</b>	<b>NAME</b>	<b>NAME</b>
.....	.....	.....
<b>SIGNATURE</b>	<b>SIGNATURE</b>	<b>SIGNATURE</b>

Job Spec. No 499/3  
Revision 0  
Date 05-04-2011  
Page 74/89

(example)

OWNER		SPREAD	
: HELLENIC GAS TRANSMISSION SYSTEM OPERATOR (DESFA S.A.)		:	
PROJECT		SECTION	
: GREEK GAS PIPELINE		:	
CONTRACT NO.		REF. KM	
: .....		:	
SUPERVISION		REF. DWG's	
: .....		:	
CONTRACTOR		REPORT No.	
: .....		:	
		DATE	
		:	
		PAGE	
		:	

RIVER'S NAME	: .....
TYPE OF PIPE COATING	: .....
TYPE OF JOINT COATING	: .....
PIPE NOMINAL DIAMETER	: .....m Wall THICKNESS : .....mm
LENGTH OF FABRICATED PIPE	: .....m
LENGTH OF PIPE IN THE GROUND	: ..... CONDITION OF PIPE : .....
TYPE OF SOIL	: ..... PIPE SURFACE TO BE PROTECTED : A ..... m <sup>2</sup>

TEST RESULTS			
NATURAL POTENTIAL (NORTH SIDE) U Cu/CuSo <sub>4</sub>	=	.....	V
NATURAL POTENTIAL (SOUTH SIDE) U Cu/CuSo <sub>4</sub>	=	.....	V
RESISTANCE OF PIPE LIVE TO SOIL RA	=	.....	Ohm
SPECIFIC SOIL RESISTIVITY Rho	=	.....	Ohm cm

TIME (min)	U CuSo <sub>4</sub> "OK" / V	U CuSo <sub>4</sub> "OFF" / V	ΔU (V)	"I" CURRENT (μA)	RA (Ohms)	is μA / m <sup>2</sup>	ru Ohms.m <sup>2</sup>
3							
6							
9							
12							
15							
18							
30							

NOTES : U "OFF" measured after each 1 min period. Time interruption less than 5 sec.  
Polarisation : U "OFF" Less / Equal - 0,9 V (max 1 hour)  
ΔU = (U "ON" ) - (U "OFF")

RA = dV / I (Ohm) - 
 is = I / A (mA / m<sup>2</sup>)


Are the C.P. results Satisfactory : YES / NO .....

<b>CONTRACTOR</b> NAME  _____ SIGNATURE	<b>SUPERVISION</b> NAME  _____ SIGNATURE
---	--

Job Spec. No 499/3  
 Revision 0  
 Date 05-04-2011  
 Page 75/89

(example)

		<b>APPENDIX E - FIG. 7</b>	
<b>CATHODIC PROTECTION        TEST REPORT FOR RIVER CROSSING</b>			
OWNER	: HELLENIC GAS TRANSMISSION SYSTEM OPERATOR (DESFA S.A.)	SPREAD	
PROJECT	: GREEK GAS PIPELINE	SECTION	
CONTRACT NO.	: .....	REF K. POINT	
CONTRACTOR	: .....	REF Km	
		REF DWG	
		REPORT No.	
		DATE	
		PAGE	

Rivers name	Type of joint coating
Type of pipe coating	Length of fabricated pipe
Pipe nominal diameter      Wall thick.      mm	Condition of pipe
Pipe reinforced in concrete	YES      NO


1st PHASE	2st PHASE
AFTER COMPLETION OF CONCRETING	AFTER PIPELINE INSTALLATION IN RIVER
1 Resistance measurements Pipeline / Reinforcement Ωhms	1 Resistance measurements Pipeline / Reinforcement Ωhms
	2 Natural potential measurements on both sides ${}^u\text{Cu} / \text{CuSO}_4 = \quad \text{V}$
	3 Resistance measurement to earth Ωhms
	4 Distance of measuring electrode depending the pipe length installed
	5 Soil resistivity measurements on both sides As per form 19.4 attached
	6 After installation of a temporary impressed current system As per form 19.5 attached
ARE C.P. RESULTS SATISFACTORY ?      YES      NO	
REMARKS:	

CONTRACTOR	SUPERVISION
NAME :	NAME :

Job Spec. No 499/3  
Revision 0  
Date 05-04-2011  
Page 76/89

(example)


		<b>APPENDIX E - FIG. 8</b>	
<b>CATHODIC PROTECTION</b>			
<b>TEST REPORT FOR ROAD / RAILWAY CROSSING WITH CASING</b>			
OWNER	: HELLENIC GAS TRANSMISSION SYSTEM OPERATOR (DESFA S.A.)	SPREAD	
PROJECT	: GREEK GAS PIPELINE	SECTION	
CONTRACT NO.	: .....	REPORT No.	
CONTRACTOR	: .....	DATE	
		PAGE	
Location	Casing nominal diameter W. Thick.		
Casing No	Casing length		
Name of casing	Uncoated	YES   NO	
Date installed	Type of coating		
	Carrier pipe length		
1st PHASE	2st PHASE	3st PHASE	
When pipe is inside casing	When Tie in works are completed on both sides	When pipe is backfilled on both sides	
1 Resistance measurements between pipe-casing Ωhms	1 Resistance measurements between pipe-casing Ωhms	1 Resistance measurements between pipe-casing Ωhms	
	2 Potential measurements ${}^u\text{Cu} / \text{CuSO}_4 = \text{ V}$	2 Potential measurements ${}^u\text{Cu} / \text{CuSO}_4 = \text{ V}$	
	3 Voltage between pipe-casing $\Delta U = \text{ V}$	3 Voltage between pipe-casing $\Delta U = \text{ V}$	
ARE C.P. RESULTS SATISFACTORY ? YES   NO			
Instrument used :	REMARKS:		
Serial No :			
Certificate No :			
CONTRACTOR NAME	SUPERVISION NAME		





**Job Spec. No** 499/3  
**Revision** 0  
**Date** 05-04-2011  
**Page** 79/89

(example)

	<b>APPENDIX E - FIG. 11</b>				
<b>CATHODIC PROTECTION</b>					
<b>INSULATION JOINT TEST RESULTS</b>					
<b>OWNER</b>	: HELLENIC GAS TRANSMISSION SYSTEM OPERATOR (DESFA S.A.)	<b>SPREAD</b>	:		
<b>PROJECT</b>	: GREEK GAS PIPELINE	<b>SECTION</b>	:		
<b>CONTRACT NO.</b>	: .....	<b>REF K. POINT</b>	:		
<b>SUPERVISION</b>	: .....	<b>LOCATION (km)</b>	:		
<b>CONTRACTOR</b>	: .....	<b>REF DWG' s</b>	:		
		<b>REPORT No.</b>	:		
		<b>DATE</b>	:		
		<b>PAGE</b>	:		

Manufacturer :	Serial No. :	Size :	Km. :	CONTR. SIGN	SUP. SIGN
Test Data	RESISTANCE		Dates		
Before Weld					
After Welding					
Before Backfill					
After Backfill					
Before Hydro - Test					
After Hydro - Test					
<b>COMMENTS :</b>					
Instrument used :					
Serial No. :					
Calib. Certified No :					
Test carried out By :		Name :		Signature :	
				Date :	

<b>CONTRACTOR</b> <b>NAME</b>  <hr/> <b>SIGNATURE</b>	<b>SUPERVISION</b> <b>NAME</b>  <hr/> <b>SIGNATURE</b>
--	---

**Job Spec. No** 499/3  
**Revision** 0  
**Date** 05-04-2011  
**Page** 80/89

**APPENDIX F**













**Job Spec. No** 499/3  
**Revision** 0  
**Date** 05-04-2011  
**Page** 85/89

(example)

	<b>APPENDIX F - FIG. 5</b>																												
<p><u>NO. ....</u>  <u>PROTOCOL</u>  for  <u>RIVER CROSSINGS</u></p>																													
<b>OWNER</b> : HELLENIC GAS TRANSMISSION SYSTEM OPERATOR (DESFA S.A.) <b>PROJECT</b> : GREEK GAS PIPELINE <b>CONTRACT NO.</b> : ..... <b>SUPERVISION</b> : ..... <b>CONTRACTOR</b> : .....	<b>SPREAD</b> : <b>SECTION</b> : <b>REF K. POINT</b> : <b>REF DWG' s</b> : <b>REPORT No.</b> : <b>DATE</b> : <b>PAGE</b> :																												
<ul style="list-style-type: none"> <li>- River Crossing Name and Number : .....</li> <li>- Location : .....</li> <li>- Pipe Diameter : .....</li> </ul>																													
<table style="width: 100%; border-collapse: collapse;"> <thead> <tr> <th style="width: 80%;"></th> <th style="width: 10%; text-align: center;">SIGNATURE</th> <th style="width: 10%; text-align: center;">DATE</th> </tr> </thead> <tbody> <tr> <td>- Acceptance of Trench / Diving Survey</td> <td style="text-align: center;">.....</td> <td style="text-align: center;">.....</td> </tr> <tr> <td>- Acceptance of Welds</td> <td style="text-align: center;">.....</td> <td style="text-align: center;">.....</td> </tr> <tr> <td>- Acceptance of Hydr. Pressure Test</td> <td style="text-align: center;">.....</td> <td style="text-align: center;">.....</td> </tr> <tr> <td>- Acceptance of Concrete Coating or Concrete Saddles</td> <td style="text-align: center;">.....</td> <td style="text-align: center;">.....</td> </tr> <tr> <td>- Acceptance of Concrete Coated Field Joints</td> <td style="text-align: center;">.....</td> <td style="text-align: center;">.....</td> </tr> <tr> <td>- Acceptance of Pipe Lowering &amp; Final Diving Survey after Lowering</td> <td style="text-align: center;">.....</td> <td style="text-align: center;">.....</td> </tr> <tr> <td>- Acceptance of Backfilling</td> <td style="text-align: center;">.....</td> <td style="text-align: center;">.....</td> </tr> <tr> <td>- Reinstatement</td> <td style="text-align: center;">.....</td> <td style="text-align: center;">.....</td> </tr> </tbody> </table>				SIGNATURE	DATE	- Acceptance of Trench / Diving Survey	.....	.....	- Acceptance of Welds	.....	.....	- Acceptance of Hydr. Pressure Test	.....	.....	- Acceptance of Concrete Coating or Concrete Saddles	.....	.....	- Acceptance of Concrete Coated Field Joints	.....	.....	- Acceptance of Pipe Lowering & Final Diving Survey after Lowering	.....	.....	- Acceptance of Backfilling	.....	.....	- Reinstatement	.....	.....
	SIGNATURE	DATE																											
- Acceptance of Trench / Diving Survey	.....	.....																											
- Acceptance of Welds	.....	.....																											
- Acceptance of Hydr. Pressure Test	.....	.....																											
- Acceptance of Concrete Coating or Concrete Saddles	.....	.....																											
- Acceptance of Concrete Coated Field Joints	.....	.....																											
- Acceptance of Pipe Lowering & Final Diving Survey after Lowering	.....	.....																											
- Acceptance of Backfilling	.....	.....																											
- Reinstatement	.....	.....																											
<b>REMARKS :</b>  The River Crossing has been completed in accordance with the Project Specifications and Drawings																													
<b>CONTRACTOR</b> <b>NAME :</b>  <hr style="width: 100%;"/> <b>SIGNATURE</b>	<b>SUPERVISION</b> <b>NAME :</b>  <hr style="width: 100%;"/> <b>SIGNATURE</b>																												


Job Spec. No 499/3  
Revision 0  
Date 05-04-2011  
Page 86/89

(example)

	<b>APPENDIX F - FIG. 6</b>																									
<p><u>NO. ....</u> <u>PROTOCOL</u> for <u>AUGER BORED CROSSINGS</u></p>																										
<p>OWNER : HELLENIC GAS TRANSMISSION SYSTEM OPERATOR (DESFA S.A.)</p> <p>PROJECT : GREEK GAS PIPELINE</p> <p>CONTRACT NO. : .....</p> <p>SUPERVISION : .....</p> <p>CONTRACTOR : .....</p>	<p>SPREAD :</p> <p>SECTION :</p> <p>REF K. POINT :</p> <p>REF DWG' s :</p> <p>REPORT No. :</p> <p>DATE :</p> <p>PAGE :</p>																									
<table style="width: 100%; border-collapse: collapse;"> <tr> <td style="width: 40%;">- Location</td> <td style="width: 10%;">:</td> <td style="width: 50%;">.....</td> </tr> <tr> <td>- Boring Number as per Index</td> <td>:</td> <td>.....</td> </tr> <tr> <td>- Type of Crossing</td> <td>:</td> <td>.....</td> </tr> <tr> <td>- Casing Diameter</td> <td>:</td> <td>.....</td> </tr> <tr> <td>- Casing Length</td> <td>:</td> <td>.....</td> </tr> <tr> <td>- Acceptance of Welds</td> <td>:</td> <td>signature ..... date .....</td> </tr> <tr> <td>- Acceptance of C.P.</td> <td>:</td> <td>signature ..... date .....</td> </tr> <tr> <td>- Site Cleaning - Reinstatement</td> <td>:</td> <td>signature ..... date .....</td> </tr> </table>			- Location	:	.....	- Boring Number as per Index	:	.....	- Type of Crossing	:	.....	- Casing Diameter	:	.....	- Casing Length	:	.....	- Acceptance of Welds	:	signature ..... date .....	- Acceptance of C.P.	:	signature ..... date .....	- Site Cleaning - Reinstatement	:	signature ..... date .....
- Location	:	.....																								
- Boring Number as per Index	:	.....																								
- Type of Crossing	:	.....																								
- Casing Diameter	:	.....																								
- Casing Length	:	.....																								
- Acceptance of Welds	:	signature ..... date .....																								
- Acceptance of C.P.	:	signature ..... date .....																								
- Site Cleaning - Reinstatement	:	signature ..... date .....																								
<p>REMARKS :</p> <p style="text-align: center;">The Auger Crossing has been completed in accordance with the Specifications and Drawings</p>																										
<p>CONTRACTOR</p> <p>NAME :</p> <p>_____</p> <p>SIGNATURE</p>	<p>SUPERVISION</p> <p>NAME :</p> <p>_____</p> <p>SIGNATURE</p>																									

Job Spec. No 499/3  
Revision 0  
Date 05-04-2011  
Page 87/89

(example)


		<p><b>APPENDIX F - FIG. 7</b></p> <p><b><u>BORING REPORT</u></b> <b><u>SURVEYING DATA</u></b></p>	
OWNER	: HELLENIC GAS TRANSMISSION SYSTEM OPERATOR (DESFA S.A.)	SPREAD	:
PROJECT	: GREEK GAS PIPELINE	SECTION	:
CONTRACT NO.	: .....	REF K. POINT	:
SUPERVISION	: .....	REF DWG' s	:
CONTRACTOR	: .....	REPORT No.	:
		DATE	:
		PAGE	:
Location	:		
Crossing No.	:		
Name of Crossing	:		
<b>LEVELS</b>		<b>DESIGN</b>	<b>AS BUILT</b>
Front end pipe			
Rear end pipe			
Inclination			
<b>LENGTHS</b>			
Front end pipe / CL crossing			
Rear end pipe / CL crossing			
<b>HORIZONTAL DEVIATION</b>			
Front end pipe			
Rear end pipe			
<b>ALIGNMENT CHECK (every 4 meters)</b>			
REMARKS :			
CONTRACTOR		SUPERVISION	
NAME :		NAME :	
_____		_____	
SIGNATURE		SIGNATURE	





Job Spec. No 499/3  
Revision 0  
Date 05-04-2011  
Page 89/89

(example)

		<b>APPENDIX F - FIG. 9</b>			
<b>REPORT No</b>					
<b><u>MARKER POST INSTALLATION REPORT</u></b>					
<b>OWNER</b>	: HELLENIC GAS TRANSMISSION SYSTEM OPERATOR (DESFA S.A.)	<b>SPREAD</b>	:		
<b>PROJECT</b>	: GREEK GAS PIPELINE	<b>SECTION</b>	:		
<b>CONTRACT NO.</b>	: .....	<b>REF. K POINT</b>	:		
<b>SUPERVISION</b>	: .....	<b>LOCATION (km)</b>	:		
<b>CONTRACTOR</b>	: .....	<b>REF. DWG's</b>	:		
		<b>REPORT No.</b>	:		
		<b>DATE</b>	:		
		<b>PAGE</b>	:		

S/N	MARKER POST LOCATION ( REV. 10)		DISTANCE FROM PIPELINE	TANGENT DISTANCES		REMARKS
	K point + m	km		SOUTH-EAST	NORTH-WEST	
1						
2						
<b>CONTRACTOR</b> <b>NAME :</b> <hr style="width: 100%;"/> <b>SIGNATURE</b>	<b>SUPERVISION</b> <b>NAME :</b> <hr style="width: 100%;"/> <b>SIGNATURE</b>
---	--